


17TH FLOOR

SUITE 1700
±16,763 SF

AVAILABLE
NOW

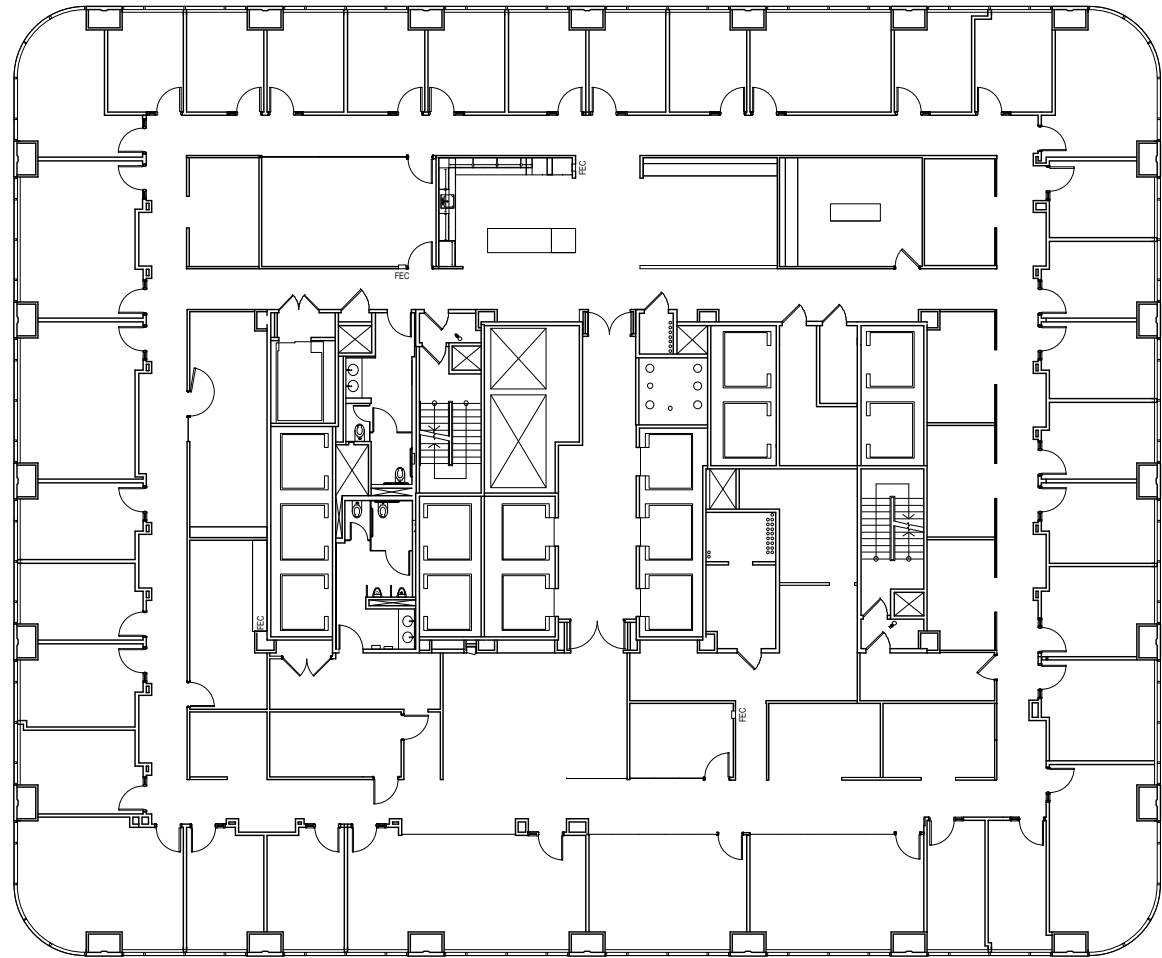

SUTTER STREET

SANSOME STREET

